

Jones County Marie Krutzfield Recorder Fee Book 2012 1005 04/16/2012 @0401PM # Pages 1 ZSC SEC COR CERT Total Fees: \$7.00

PREPARED BY: MICHAEL J. WEBER, WEBER SURVEYING, LLC, 26789 46TH AVE, BERNARD, IA 52032 (563) 879-4173

## UNITED STATES PUBLIC LAND SURVEY CORNER CERTIFICATE ΠF

LAND SURVEY MONUMENTS SITUATED IN SECTION 1, TOWNSHIP 84 NORTH, RANGE 3 WEST OF THE FIFTH PRINCIPAL MERIDIAN, JONES COUNTY, IOWA. PREVIOUSLY RECORDED NONE UNLESS NOTED BELOW (book, page, document number, etc.)

(Show reason for preparing this certificate, the evidence and detailed procedures used in establishing the corner positions and monumentation found or placed.)

Monument Description and Remarks:

WEST 1/4 COR, SEC. 1, T.84N. R.3W. OF THE 5TH P.M. FOUND 1/2" REROD W/RED CAP NO. 11954 PREVIOUSLY RECORDED AS DOC. NO. 1999 1805 ESTABLISHED NEW TIES

NE COR, NW-SW, SEC. 1, T.84N. R.3W. OF THE 5TH P.M. PLACED  $5/8^{\prime\prime}$  REROD W/DRANGE CAP NO. 15084 , ESTABLISHED CORNER MIDWAY AND ONLINE BETWEEN THE WEST 1/4 AND THE CENTER.

CENTER, SEC. 1, T.84N. R.3W. OF THE 5TH P.M. FOUND 6" X 5"X 3" STONE NEXT TO OCCUPATION FENCE RUNNING NORTH AND EAST PLACED 5/8" REROD W/ORANGE CAP NO. 15084


SW COR, SEC. 1, T.84N. R.3W. OF THE 5TH P.M. FOUND  $1/2^{\prime\prime}$  REROD W/YELLOW CAP NO. 11310 PREVIOUSLY RECORDED AS DOC. NO. 1999 1805 REMEASURED TIES

SE COR, SV-SW, SEC. 1, T.84N. R.3W. OF THE 5TH P.M. PLACED  $5/8^{\prime\prime}$  REROD W/ORANGE CAP NO. 15084 ESTABLISHED CORNER MIDWAY AND ONLINE BETWEEN THE SW CORNER AND THE S 1/4 COR.

S 1/4 COR, SEC. 1, T.84N. R.3W. OF THE 5TH P.M. FOUND 1/2" REROD W/YELLOW CAP NO. 9547 PREVIOUSLY RECORDED AS DOC. NO. 2000 35484 ESTABLISHED NEW TIES

## PLAN - VIEW

(Show a minimum of three reference ties to durable physical objects, relevant monuments and physical conditions that will enable recovery of the corner.)

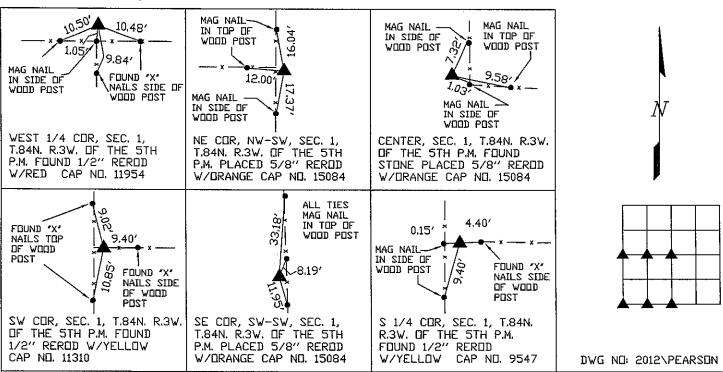

LAND MICHAEL .I WEBER 15084 AVIT 1

I HEREBY CERTIFY THAT THIS LAND SURVEYING DOCUMENT WAS PREPARED AND THE RELATED SURVEY WORK WAS PERFURMED BY ME OR UNDER MY DIRECT PERSONAL SUPERVISION AND THAT I AM A DULY LICENSED LAND SURVEYOR UNDER THE LAWS OF THE STATE OF IDWA.

MICHAEL J. WEBER

(DATE)

LICENSE NUMBER 15084

MY LICENSE RENEWAL DATE IS DECEMBER 31, 2013

Shiet SHEETS COVERED BY THIS SEAL \_\_\_

List Corners to be Indexed Sec Twp Range 84N 3W WEST 1/4 Cor. NE COR, NW-SW 84N 3W CENTER 84N 3W SW COR. 84N 3W SE COR, SW-SW 1 84N 3W S 1/4 COR. 1 84N 3W

## 2003 1072

FILED RECORDERS OFFICE JONES COUNTY 10WA

03 MAR 13 PM 1:16

MARIE KRUTZFIELD RECORDER 6.00 AL

PRE	PARED BY HALL &	HALL ENGINEEDS IN									
	- SOUTH MICH	HALL ENGINEERS, INC NUMENTS SITUATE T. OF THE FIFTH	D IN SEC	TIAN	/	~~	NSHIP	84	NORTH,		
	RECOVERY T	<u>IE DRAWING</u>							REMARKS:		
X-N GATE	AILS IN E POSTS	X-NAILS IN POWER POLE		H1/4					Z., T84N, R3		
4 13074 5	53.25' 70.76'	116.35	<b>L</b>	R MOEX	PREVIO	N FOR PREP US BOOK	ARING CER	TIFICATE: C	DB, C OR D		
24.49: 1339											
X-MAILS IN SATE POST 843025-022703											
often feild					E'4 COR1/41/4, SEC. Z_, T84N, R3W						
X-NAILS IN BRACE POST	X-NAILS IN BRACE POST  X-NAILS IN BRACE POST  7.865					REASON FOR PREPARING CERTIFICATE: (2) B, C OR D PREVIOUS BOOK SET 1/2" REBARE WITH RED L-S. CAP # 11954, FLUSH WITH GROUND ACAINST NORTH FACE OF CORNER POST					
09EN FEILD	022703	PASTURE 499	الأ								
4.32'-	40.00 30.01	- E3	CORNER II		REASON PREVIOUS FOOM!	FOR PREPAR	RING CERTIF	PAGE	DVE GROUND		
2-HAILS IN 48" COTTON WOOD >	<b>*</b> 30"	AILLS IN MAPLE US	B								
I hereby certify that this land surveying document was prepared and the related survey work was performed by me or under my direct personal supervision and that I am a duly licensed Land Surveyor under the laws of the State of lowa.  Date:  Daniel J. Johnson, L.R. 11944  My license renewal datas December 31, 2004  Pages or sheets covered by this seal:					REASON FOR PREPARING CERTIFICATE:  A) THERE IS NO CERTIFICATE FOR THE CORNER ON FILE WITH THE RECORDER OF THE COUNTY IN WHICH THE CORNER IS LOCATED.  B) CORNER POSITION DIFFERS FROM THAT SHOWN IN THE PUBLIC RECORDS OF THE COUNTY IN WHICH THE CORNER IS LOCATED.  C) THE CORNER MONUMENT HAS BEEN REPLACED OR MODIFIED.  D) THE REFERENCE TIES REFERRED TO IN AN EXISTING PUBLIC RECORD ARE INCORRECT OR MISSING.						
ject	IC LAND SUR	VEY CORNER C	RTIFICAT	Ε	H	HALL A 209 29TH CEDAR RAF	ND HAL STREET N.	L ENGI	NEERS, INC.		
	Checked by:	Approved by:	Field Book No.		Scole;	(319) 362-	-9548 Date: Z/1Z/4		Project No:		

H

FILED
RECORDERS OFFICE
JONES COUNTY IOWA

99 MAY 18 PM 3: 49

MARIE KRUTZFIELD
RECORDER 6.00 pd

BRAIN ENGINEERING, INC., 777 10TH STREET, MARION, IOWA 52302 PH. (319) 373-1318								
WOUNDS OF SURVEY CORNE								
LAND SURVEY MONUMENTS SITUATED IN SECTION <u>02</u> , TOWNSHIP <u>84</u> NORTH RANGE <u>03</u> WEST OF THE 5TH P.M., <u>JONES</u> COUNTY, IOWA.								
F 1/4  CLARENCE WALTON 11310  8.55'  FOUND X'D NAILS IN BRACE POST  FOUND X'D NAILS IN BRACE POST  PREVIOUSLY RECORDED IN BOOK PAGE MONUMENT DESCRIPTION AND HOW ESTABLISHED FOUND 1/2" REBAR #11954 AT SURFACE	SET X'D NAILS IN BRACE POST  9.13'  9.13'  SET X'D NAILS IN BRACE POST  10.86'  SET X'D NAILS IN BRACE POST  PREVIOUSLY RECORDED IN BOOK PAGE MONUMENT DESCRIPTION AND HOW ESTABLISHED SET 1/2" REBAR #11310 0.1' NE OF CORNER POST							
I hereby declare that this plat, survey or report was made by me or under my direct personal supervision and that I am a duly registered Land Surveyor under the laws of the State of Iowa Signed  Out Signed  Clarence J. Walton L.S. Iowa Reg No. 11310  My Registration Renewal Date Is December 31, 1999	CORNERS TO BE INDEXED  CORNER SECTION TOWNSHIP RANGE  E 1/4 02 T84N R3W  SE 02 T84N R3W  BRAIN ENGINEERING, INC.  777 10TH STREET  MARION, KOWA 52302  (319) 373-1318							