
Instrument #: 2015-3127
10/30/2015 10:21:15 AM Total Pages: 1
ZSC SECTION CORNER CERTIFICATE
Recording Fee: \$7.00 Transfer Tax: \$0
Sheri L. Jones, Recorder, Jones County Iowa

## 

Prepared by/Return to: FEHR GRAHAM, 1919 210th Street, Manchester IA 52057 - Ph: (563)927-2060 UNITED STATES PUBLIC LAND SURVEY CORNER CERTIFICATE Land Survey Monuments situated in Section \_\_\_\_\_16\_\_\_ , Township \_\_ \_\_ North, Range West of the Fifth Principal Meridian, \_\_\_ County, Iowa. Previously recorded in (1) Bk. 1999, Pg. 3194 (2) Bk. 1999, Pg. 3193 in County Recorder's Office. (book, page, document number, etc.) (Show reason for preparing this certificate, the evidence and detailed procedures used in establishing the corner positions and monumentation found or placed.) Monument Description and Remarks: (1) E1/4 Corner of Section 16-T85N-R3W: Section corner information was obtained before and set after concrete overlay project. Found cut "x" and concrete nail in pavement before P.C.C. overlay. Set mag nail in cut "x" in P.C.C. pavement and three new ties. (2) SE Corner of Section 16-T85N-R3W: Section corner information was obtained before and set after concrete overlay project. Found PK nail before P.C.C. overlay. Set mag nail in cut "x" in P.C.C. pavement and three new ties. PLAN VIEW Project Number 15-321 Show a minimum of three reference ties to durable physical objects, relevant monuments and physical conditions that will enable recovery of the corner. Wayne Twp. 2 Set Orange Plastic Tag #7060 on Power Pole Co Rd X-44 STA 119+04.98 5.28 . Orange Plastic #7060 on <u>€</u> Co Rd E-17 Placed Cut 'X' on East 36" © Culvert <u>\*</u>! Found GPS Monument #30 윤 (1) E1/4 Corner of Sec. 16-T85N-R3W (2) SE Corner of Sec. 16-T85N-R3W Set Mag Nail in Cut "X" in P.C.C. Pavement Set Mag Nail in Cut "X" in P.C.C. Pavement

I hereby certify that this land surveying document was prepared and the related survey work was performed by me or under my direct personal supervision and that I am a duly licensed Land Surveyor under the laws of the State of lowa. TeKIPPE 7060 10-28-15 Lyle 0. TeKippe, P.E. & J.S. License Number: 7060 My license renewal date is December 31, 2016. eets covered by this seal: This Sheet Only

List	List Corners to be Indexed		
Corners	Section	Twp.	Range
E1/4	16	85N	3W
SE	16	85N	3W
3:\C3D\15\15-3:	21\15-321-LEGAL	.dwg	

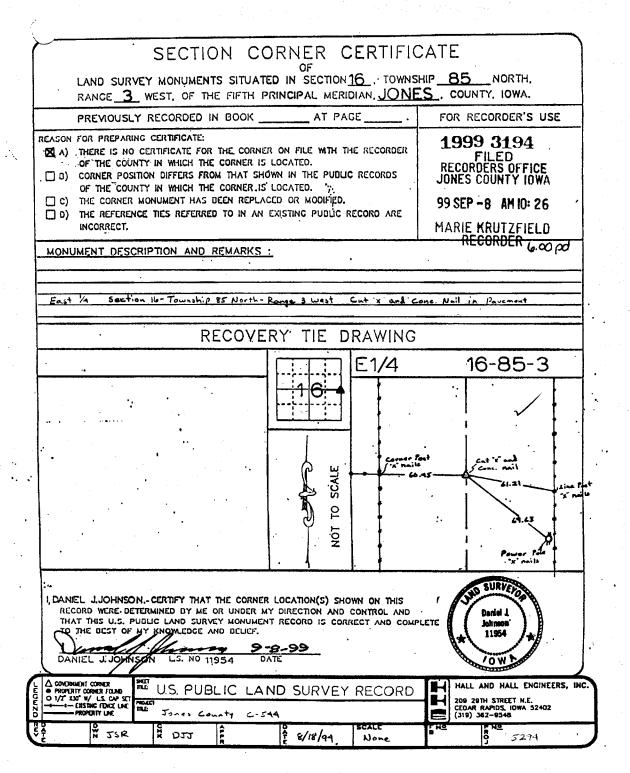

853160-090899