

COPY

Jones County Marie Krutzfield Recorder  
 Fee Book 2012 2716  
 09/17/2012 @1143AM # Pages 1  
 ZSC SEC COR CERT  
 Total Fees: \$0.00



PREPARED BY  
 CLARENCE J. WALTON, JONES COUNTY ENGINEER'S OFFICE, 19501 HWY. 64, ANAMOSA, IOWA, 52205 (319) 462-3785

UNITED STATES PUBLIC LAND  
 SURVEY CORNER CERTIFICATE  
 LAND SURVEY MONUMENTS SITUATED IN SECTION 17, TOWNSHIP 85 NORTH,  
 RANGE 3 WEST OF THE 5TH PRINCIPAL MERIDIAN, JONES COUNTY, IOWA.

N 1/4 CORNER SECTION 17-T85N-R3W  
 STATE PLANE COORDINATE (NAD 83 IOWA NORTH)  
 N 3536858.01  
 E 5539354.38

CORNER SECTION TOWNSHIP RANGE  
 N 1/4 17 T85N R3W

NOTE:  
 THE STATE PLANE COORDINATE AS  
 INDICATED IS FOR CONVENIENCE ONLY.  
 THE TIES AS SHOWN SHOULD BE USED TO  
 REPLACE THE CORNER, IF DESTROYED

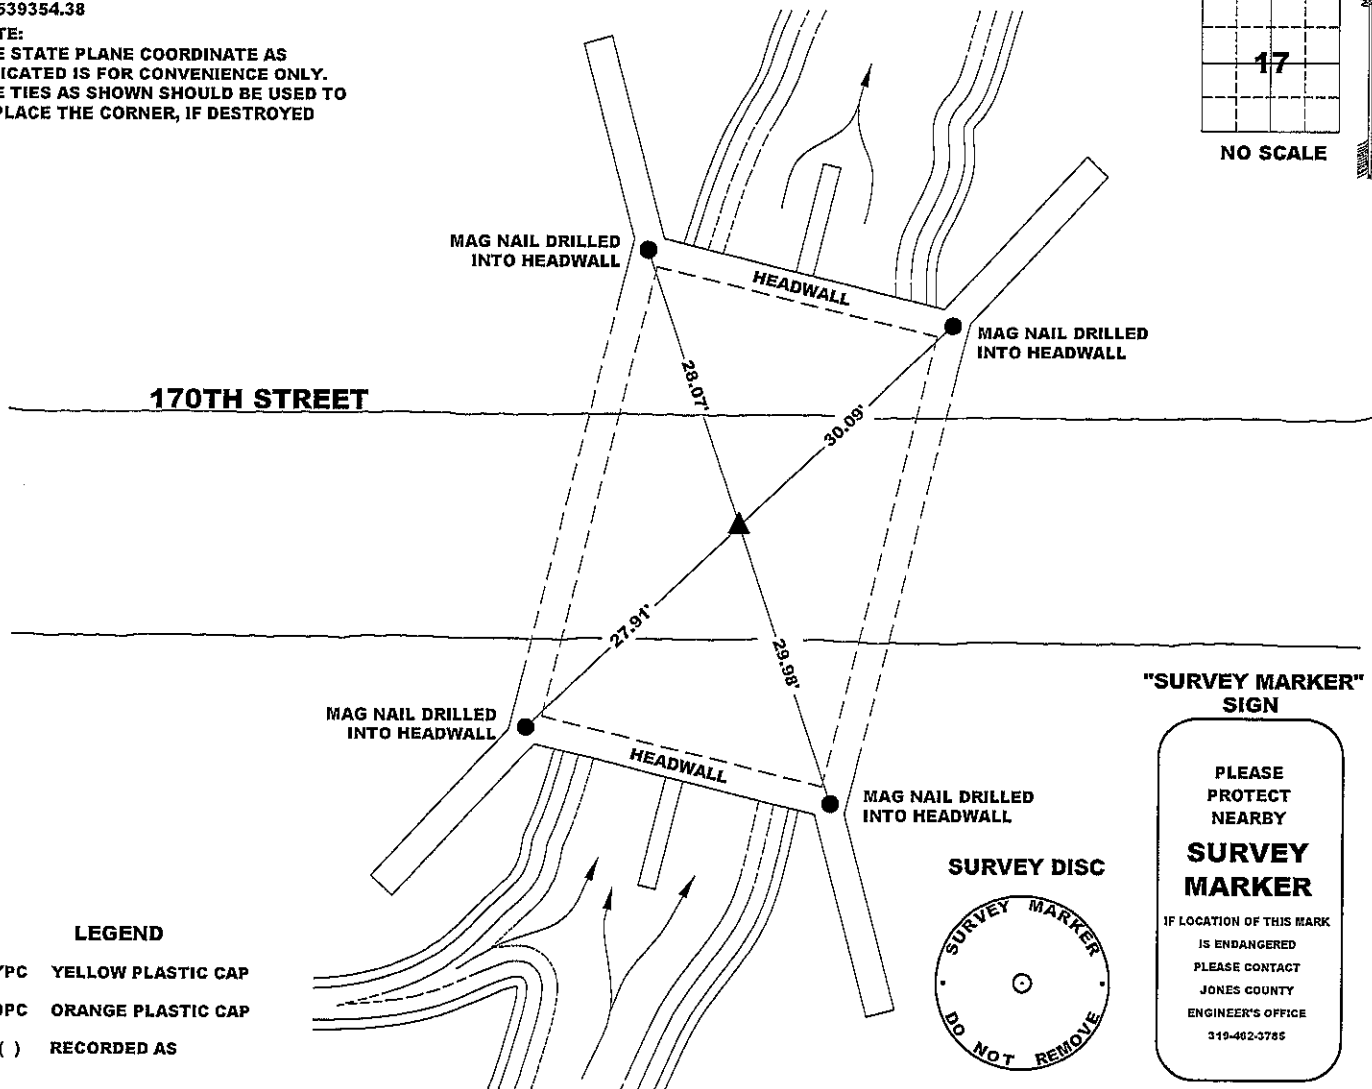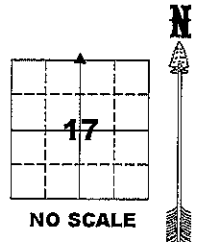


- LEGEND**
- YPC YELLOW PLASTIC CAP
  - OPC ORANGE PLASTIC CAP
  - ( ) RECORDED AS

PREVIOUSLY RECORDED IN RECORDER'S DOCUMENT 1999 0330

MONUMENT DESCRIPTION AND HOW ESTABLISHED FOUND 1/2" REBAR 4" BELOW PRESENT ROAD SURFACE OVER TOP OF REINFORCED CONCRETE BOX CULVERT.

FIELD BOOK 1965-1966, PAGE 58. DATE OF SURVEY: 9/14/12

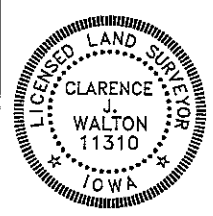

I hereby certify that this land surveying document and the related survey work was performed by me or under my direct personal supervision and that I am a duly registered Land Surveyor under the laws of the State of Iowa.  
 Signed: *Clarence J. Walton* 9/17/12  
 Clarence J. Walton, L.S.  
 My Registration Renewal Date is December 31, 2013  
 Iowa License Number 11310  
 Pages or sheets covered by this seal: 1 of 1

- A. THERE IS NO CERTIFICATE FOR THE CORNER ON FILE WITH THE RECORDER OF THE COUNTY IN WHICH THE CORNER IS LOCATED.
- B. THE CORNER MONUMENT HAS BEEN REPLACED OR MODIFIED.
- C. THE SURVEYOR IN RESPONSIBLE CHARGE OF THE LAND SURVEYING ACCEPTS A CORNER POSITION THAT DIFFERS FROM THAT SHOWN IN IN THE PUBLIC RECORDS OF THE COUNTY IN WHICH THE CORNER IS LOCATED.
- D. THE REFERENCE TIES REFERRED TO IN AN EXISTING PUBLIC RECORD NO LONGER EXIST.
- E. ADDED TIES TO FACILITATE LOCATING SECTION CORNER MONUMENT.

CORNERS TO BE INDEXED

CORNER	SECTION	TOWNSHIP	RANGE
N 1/4	17	85N	3W
S 1/4	8	85N	3W

JONES COUNTY ENGINEER'S OFFICE




19501 HWY. 64, ANAMOSA, IOWA 52205  
 (319) 462-3785

UNITED STATES PUBLIC SECTION CORNER CERTIFICATION  
AND LAND CORNER SURVEY  
SECTION 17 T-85N R-3W


MADE FOR  
IOWA DEPARTMENT OF TRANSPORTATION FOR THE PURPOSE OF  
RIGHT OF WAY DESCRIPTIONS ON PRIMARY ROAD No. U.S. 151

MADE BY  
MICHAEL R. FAGLE R.L.S. No. 8505  
JONES COUNTY, IOWA NHS-151-3(84)--19-57  
APRIL 1998 THRU OCTOBER 1998

ALL DISTANCES WERE CAREFULLY MEASURED AND MAY NOT AGREE WITH ROAD SURVEY STATIONING











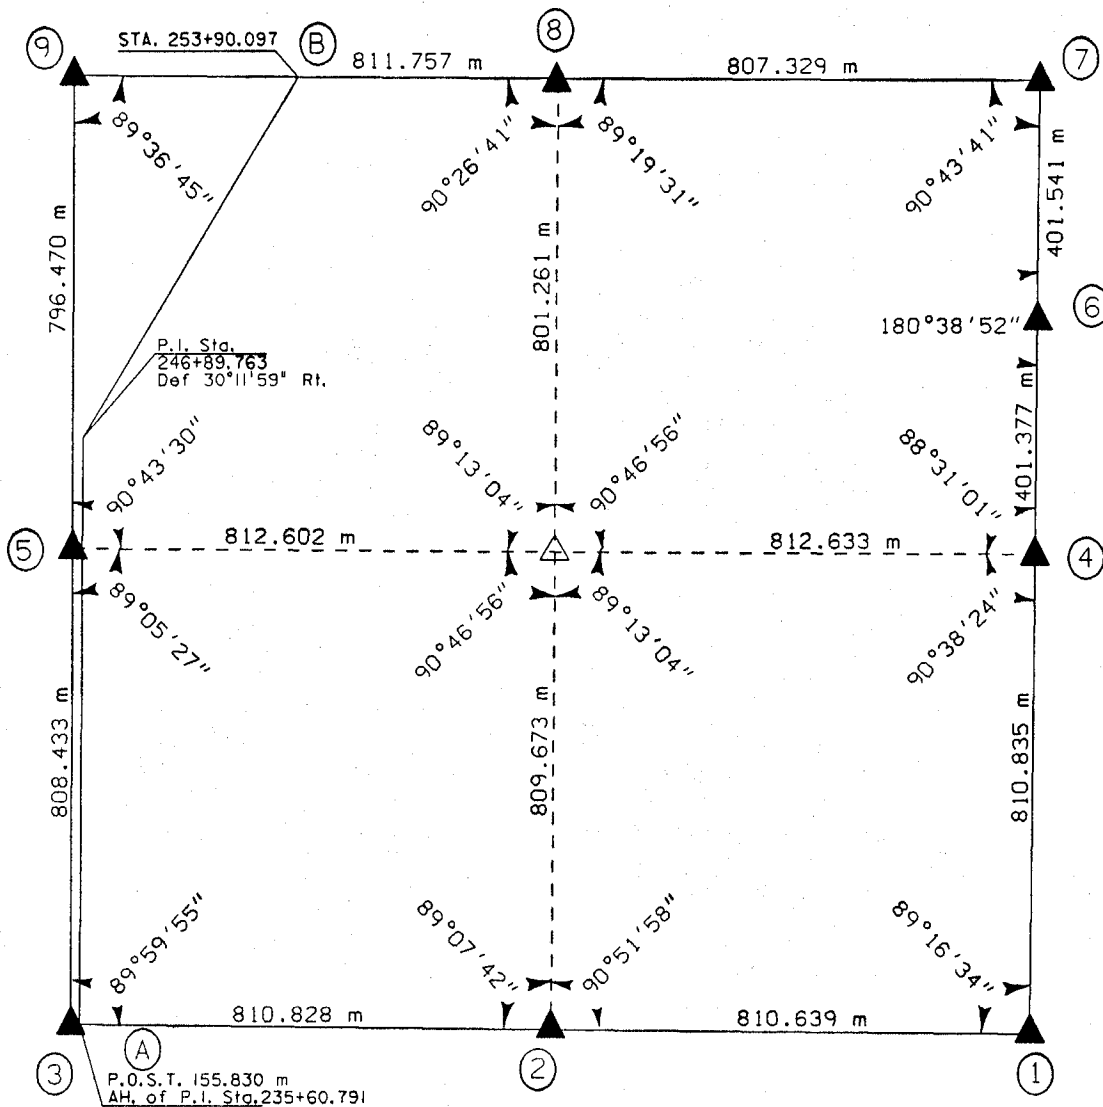


EARTH  TECH

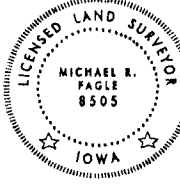	I hereby certify that this Land Surveying document was prepared by me or under my direct personal supervision and that I am a duly Licensed Land Surveyor under the laws of the State of Iowa.	
	<i>Michael R. Fagle</i>	1-21-99
	MICHAEL R. FAGLE	Date
	License number 8505	
	My license renewal date is December 31, 2000	
Pages or sheets covered by this seal:		
Two (2)		

**METRIC**

**UNITED STATES PUBLIC SECTION CORNER CERTIFICATION  
AND LAND CORNER SURVEY  
SECTION 17 T-85N R-3W**

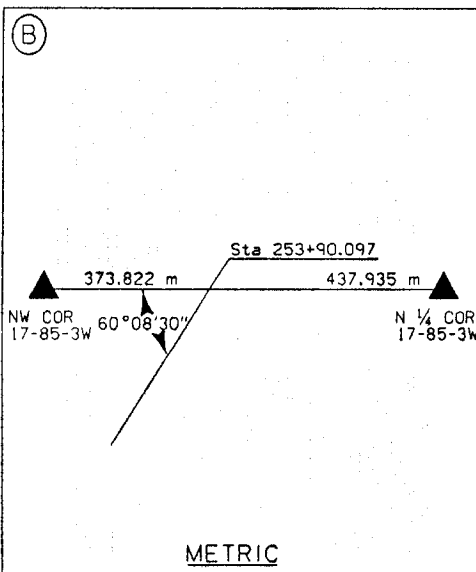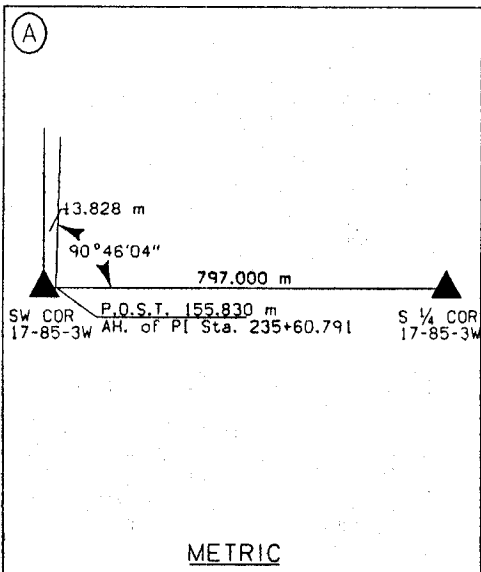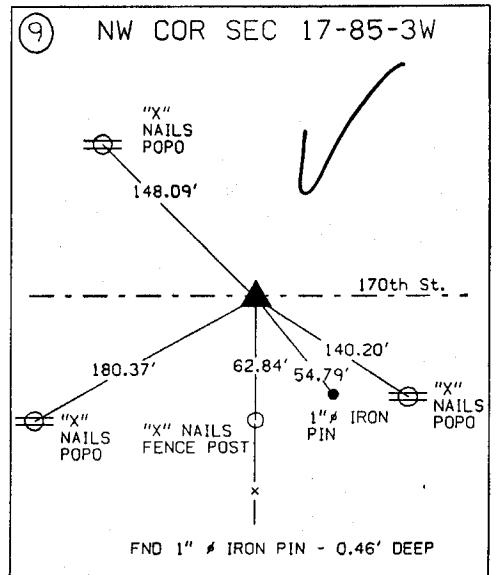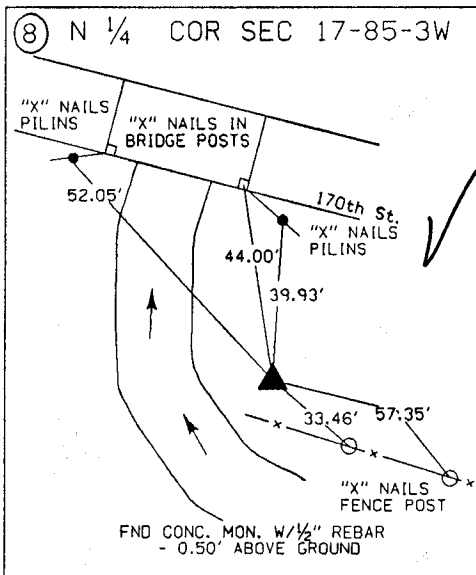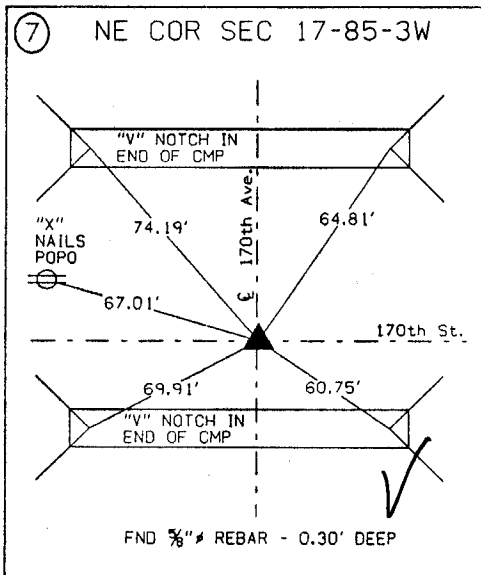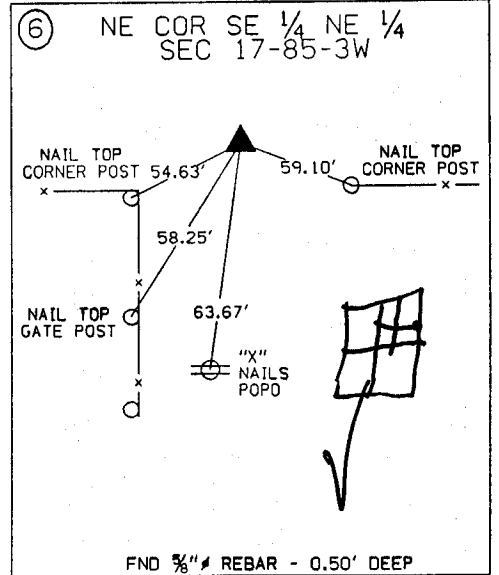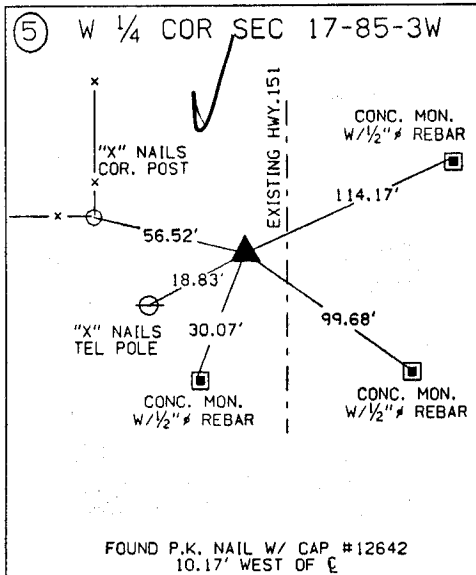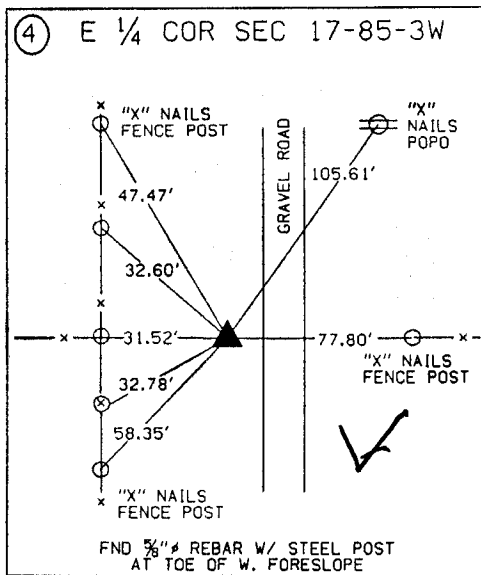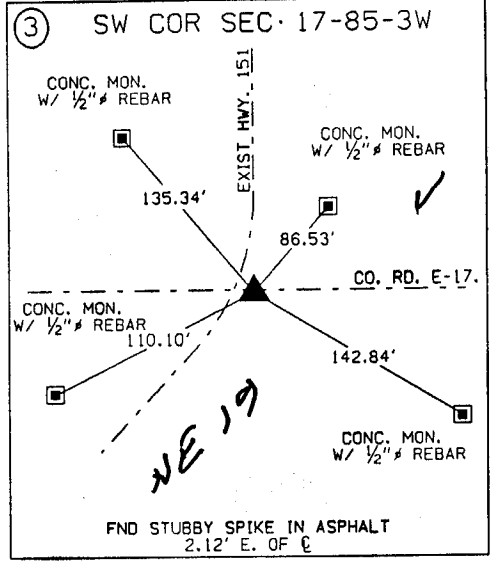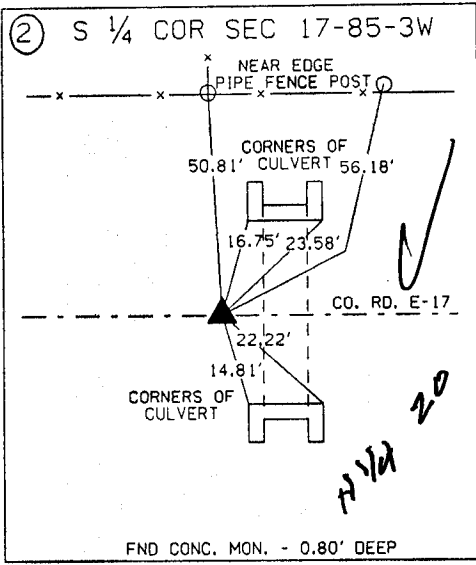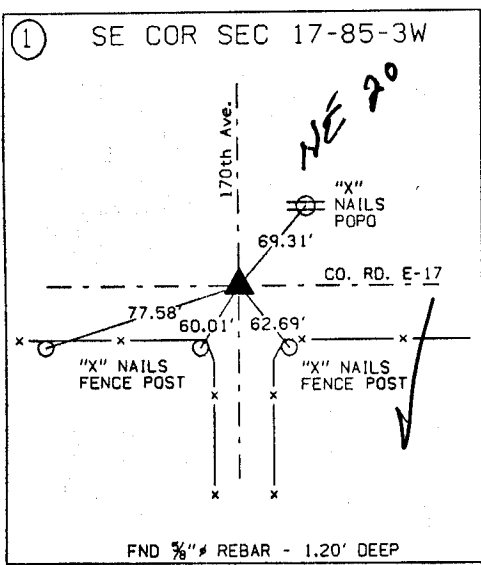

**ALL TIES ARE ENGLISH UNLESS OTHERWISE NOTED**